



**ZONE 10**

**BRIDGE**

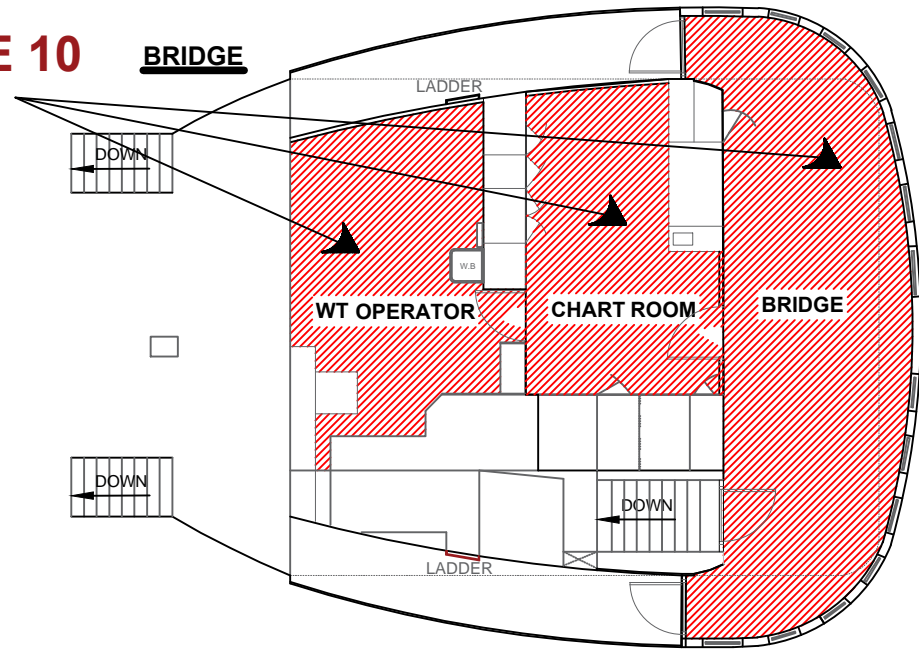


**STUDIOS**

**ZONE 9**

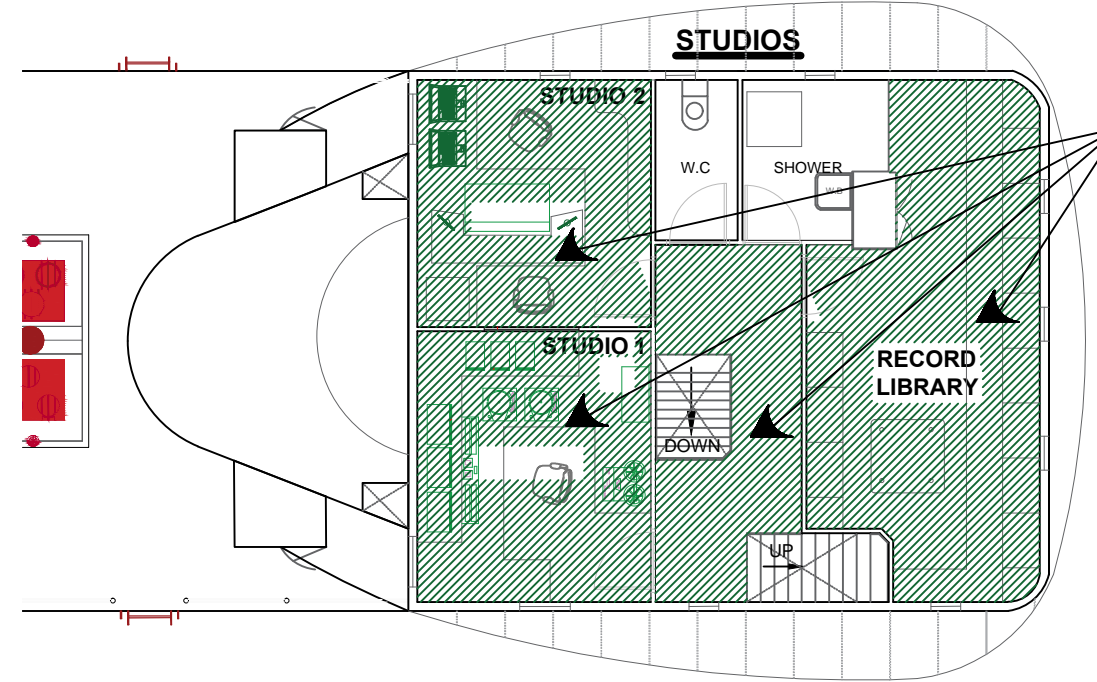

**ZONE 3 ZONE 2**

**ZONE 13**

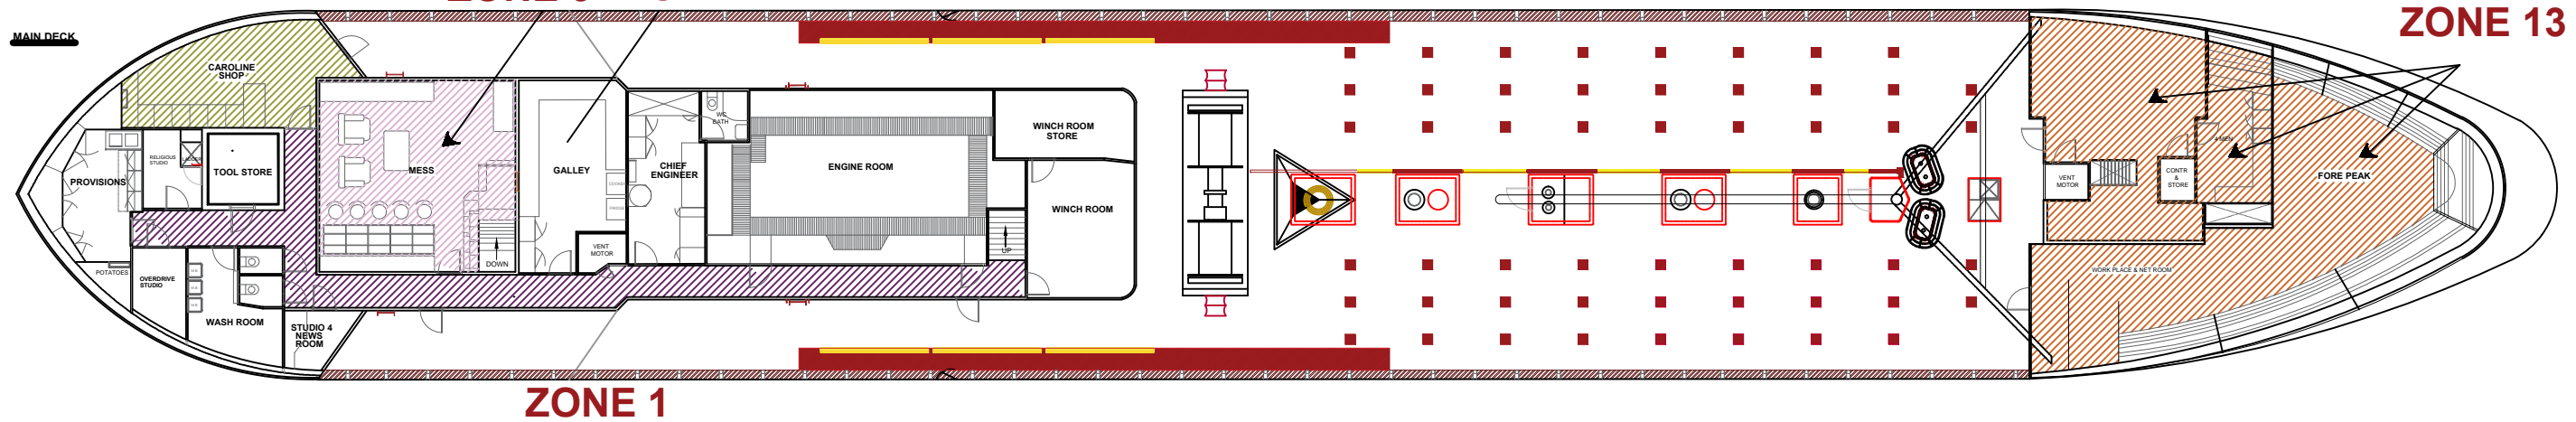


**ZONE 1**

**HOLD**

**ZONE 4**

**ZONE 11**

**ZONE 12**

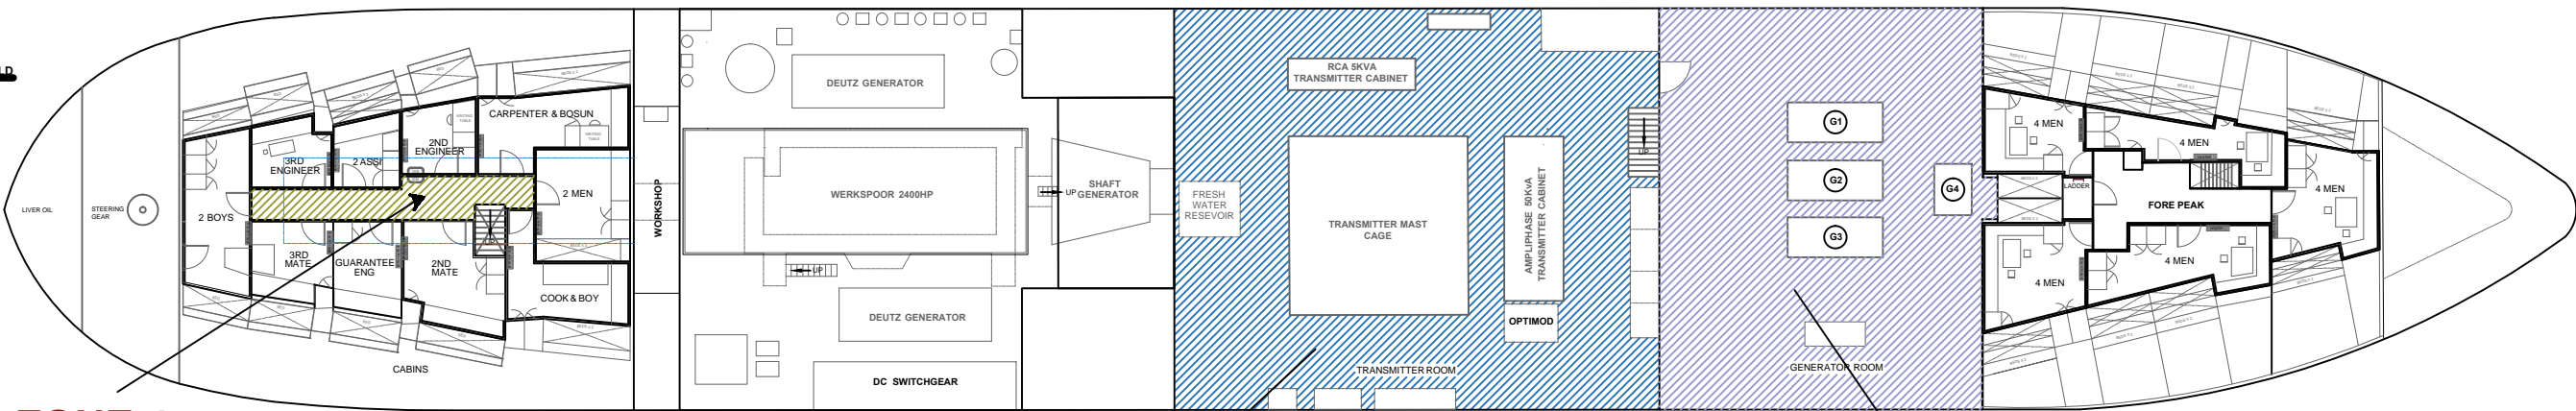

REVISONS	NOTES	PROJECT	DRAWING TITLE	Date: MAY-2015	Scale: 1:50																			
<table border="1"> <tr><td>RD</td><td>GJ</td><td>RECORD DRAWING</td></tr> <tr><td>Rev</td><td>Date</td><td>By</td><td>Description</td></tr> </table>	RD	GJ	RECORD DRAWING	Rev	Date	By	Description	<p><small>Copyright Notice</small> This drawing is subject to Copyright © Ross Revenge Plans (2015-2017) - Reg No 284707913 and may not be altered, reproduced or used other than for the purpose which it is issued.</p> <p><small>Terms of Use</small> Ross Revenge Plans utilise Digital Rights Management (DRM) on all products. Use of this file deems the recipient's acceptance of our DRM policies. Copy available on request.</p>	<b>RRP</b>	<b>ROSS REVENGE</b>	<b>FIRE ALARM ZONE PLAN</b>	<table border="1"> <tr><td>Drawn: GJ</td><td>Eng: GJ</td><td>Checked By: AB</td></tr> <tr><td>File Ref:</td><td></td><td>Sheet Size: A3</td></tr> <tr><td>Drawing No:</td><td colspan="2"><b>199-RR-FZ-001</b></td></tr> <tr><td>Scale:</td><td colspan="2">RECORD DRAWING</td></tr> </table>	Drawn: GJ	Eng: GJ	Checked By: AB	File Ref:		Sheet Size: A3	Drawing No:	<b>199-RR-FZ-001</b>		Scale:	RECORD DRAWING	
RD	GJ	RECORD DRAWING																						
Rev	Date	By	Description																					
Drawn: GJ	Eng: GJ	Checked By: AB																						
File Ref:		Sheet Size: A3																						
Drawing No:	<b>199-RR-FZ-001</b>																							
Scale:	RECORD DRAWING																							

# FIRE ZONE PLAN

A3