
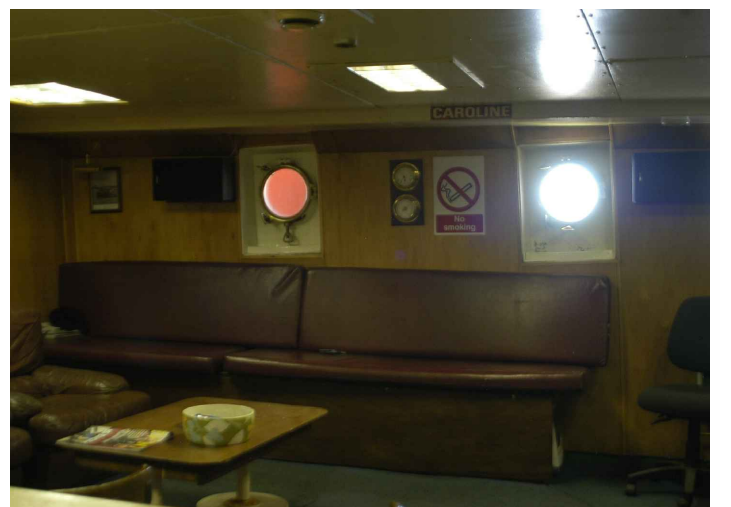


A
B
C
D

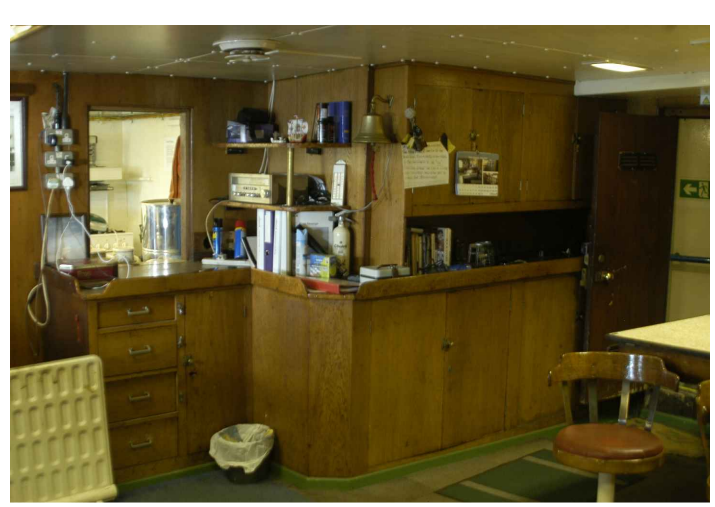

REVISIONS	NOTES		PROJECT	DRAWING TITLE	Date: FEB-2016 Scale: 1:50 Drawn: GJ Eng: GJ Checked By: AB File Ref: Sheet Size: A3 Drawing No: 319-RR-MP-001 Title: RECORD DRAWING								
<table border="1" style="width: 100%; border-collapse: collapse;"> <thead> <tr> <th>Rev</th> <th>Date</th> <th>By</th> <th>Description</th> </tr> </thead> <tbody> <tr> <td> </td> <td> </td> <td> </td> <td> </td> </tr> </tbody> </table>	Rev	Date	By	Description					<p><small>Copyright Notice</small> This drawing is subject to Copyright © Ross Revenge Plans (2015-2017) - Reg No 284707913 and may not be altered, reproduced or used other than for the purpose which it is issued.</p> <p><small>Terms of Use</small> Ross Revenge Plans utilize Digital Rights Management (DRM) on all products. Use of this file denotes the recipient's acceptance of our DRM policies. Copy available on request.</p>		ROSS REVENGE	MESS ROOM PLAN LAYOUT	A3
Rev	Date	By	Description										