


ASH ROOM




STUDIO 4 NEWS ROOM

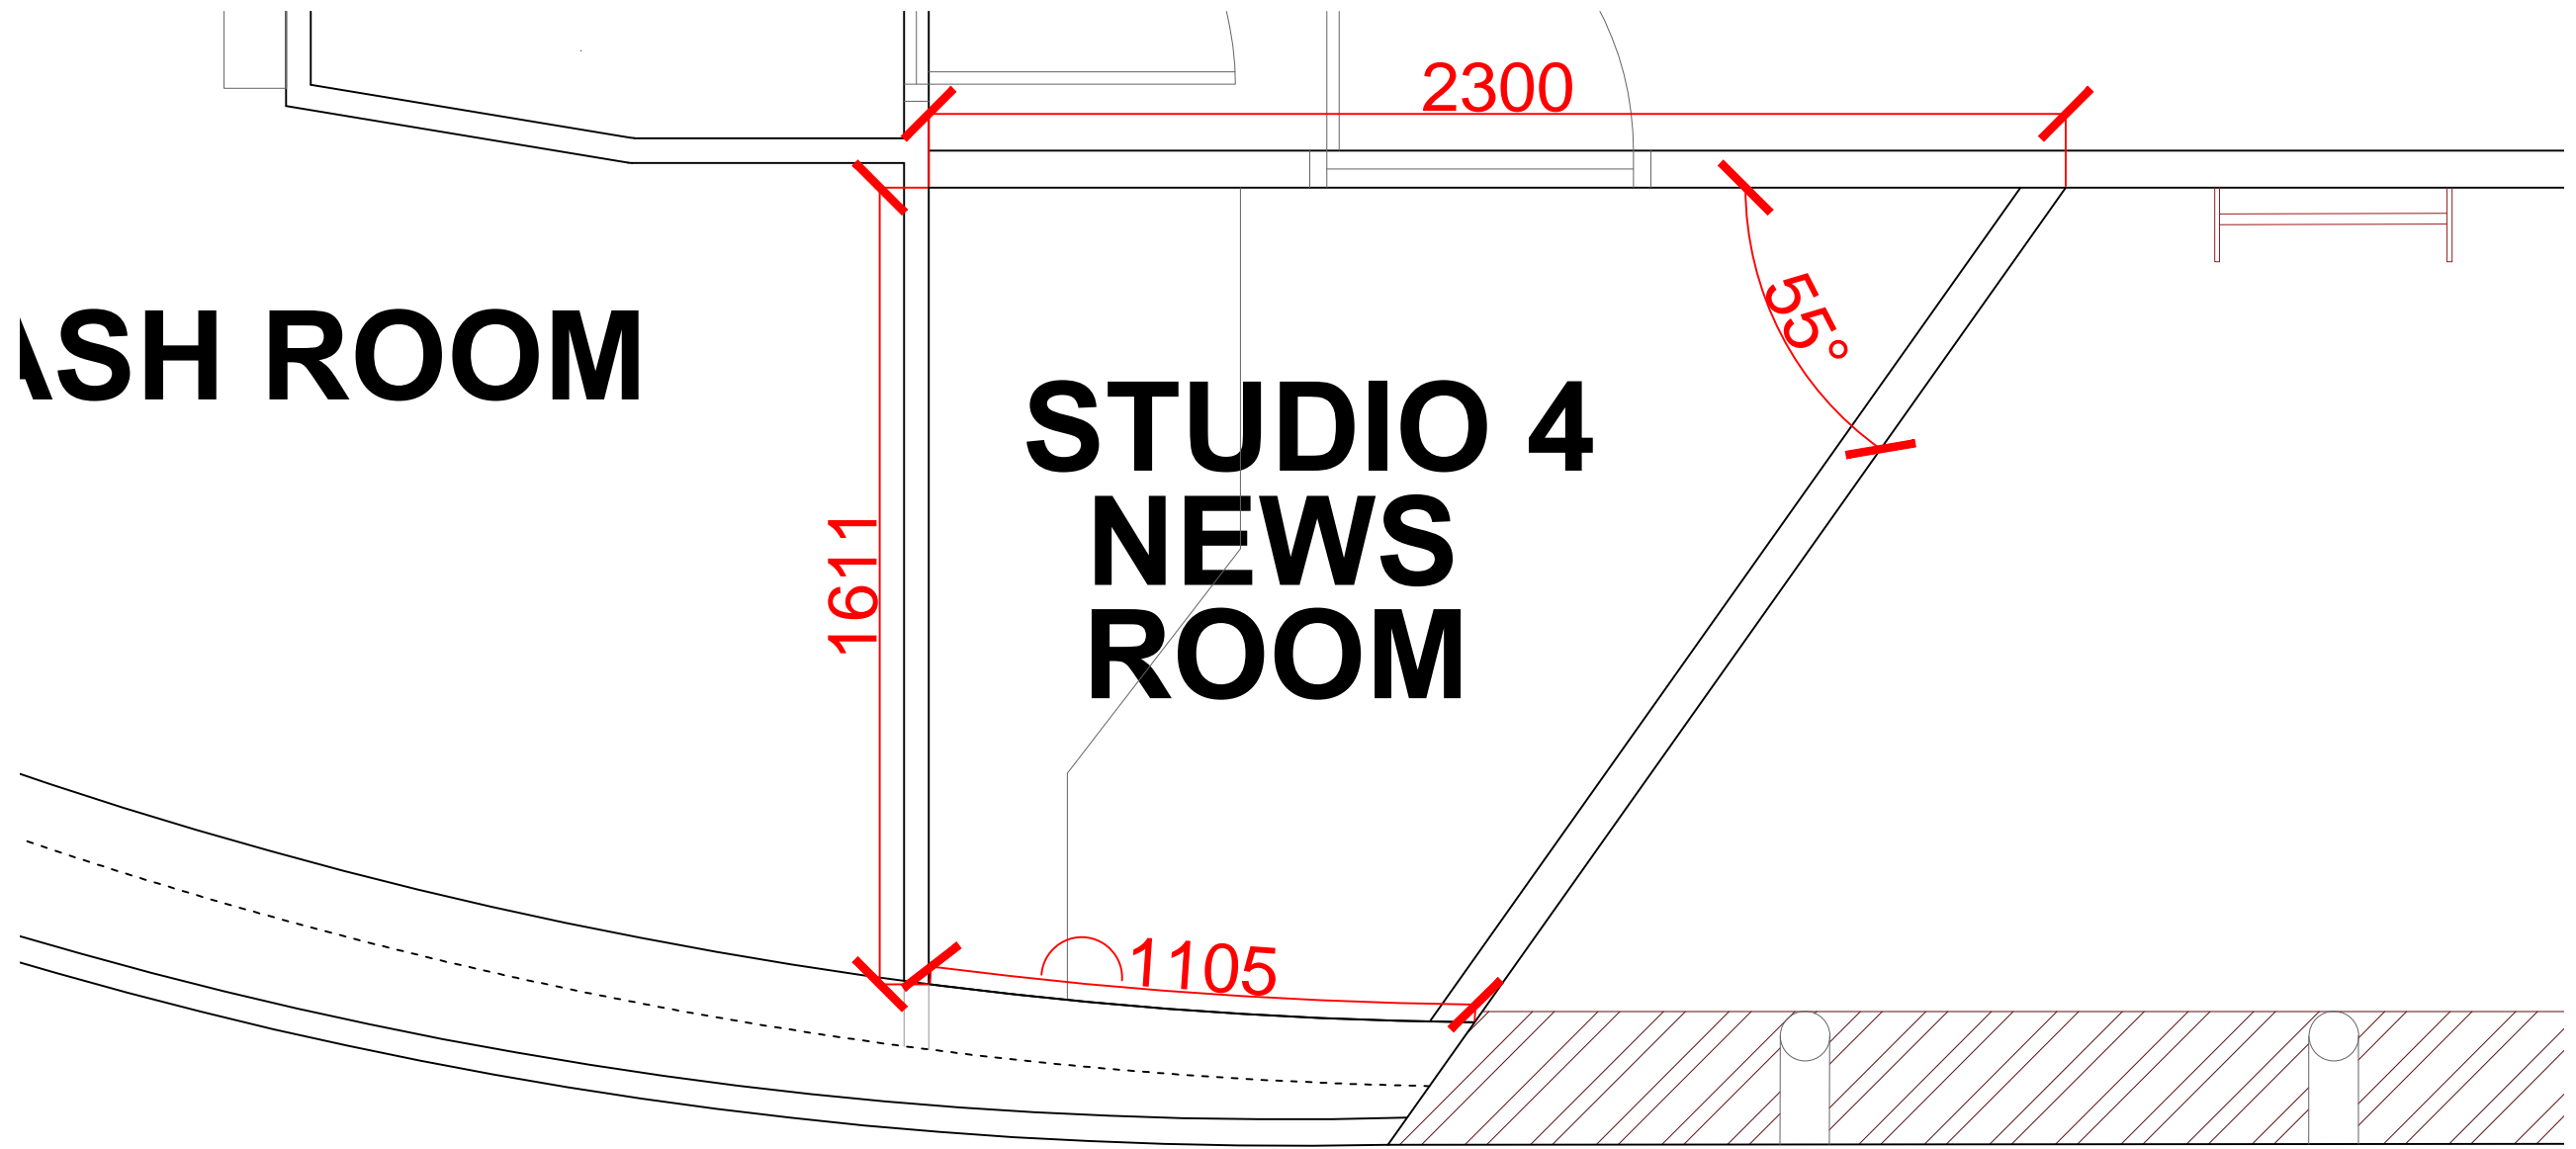

A

B

C

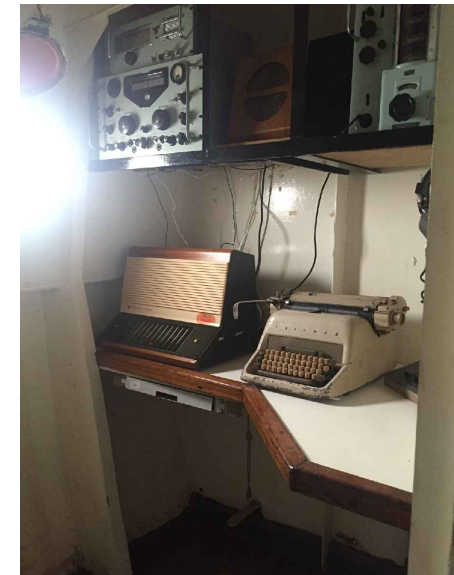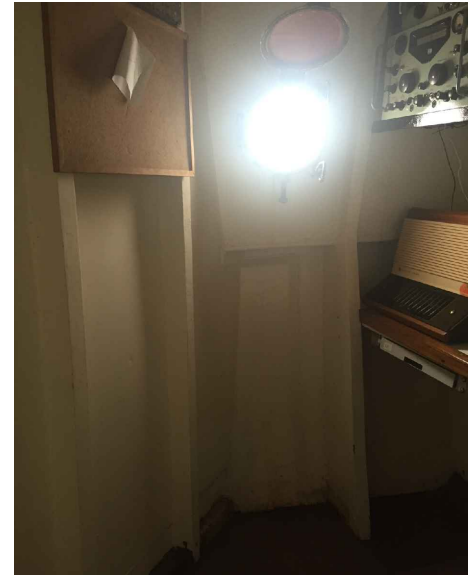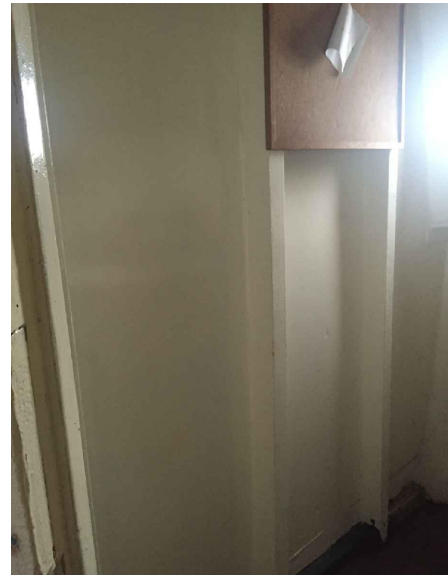

REVISIONS		NOTES	PROJECT	DRAWING TITLE	Date: FEB-2016	Scale: 1:50
RD	GJ	RECORD DRAWING	ROSS REVENGE	NEWS STUDIO PLAN LAYOUT	Drawn: GJ	Eng: GJ
Rev	Date	By			Checked By: AB	Sheet Size: A3
					Drawing No: 319-RR-MP-005	
					RECORD DRAWING	

A3



**ROSS
REVENGE**

**NEWS STUDIO
PLAN
LAYOUT**

Date: FEB-2016	Scale: 1:50
Drawn: GJ	Eng: GJ
Checked By: AB	Sheet Size: A3
Drawing No: 319-RR-MP-005	
RECORD DRAWING	