

DECK

CAROLINE SHOP




RELIGIOUS STUDIO

LADDER

TOOL STORE

MESS

PROVISIONS

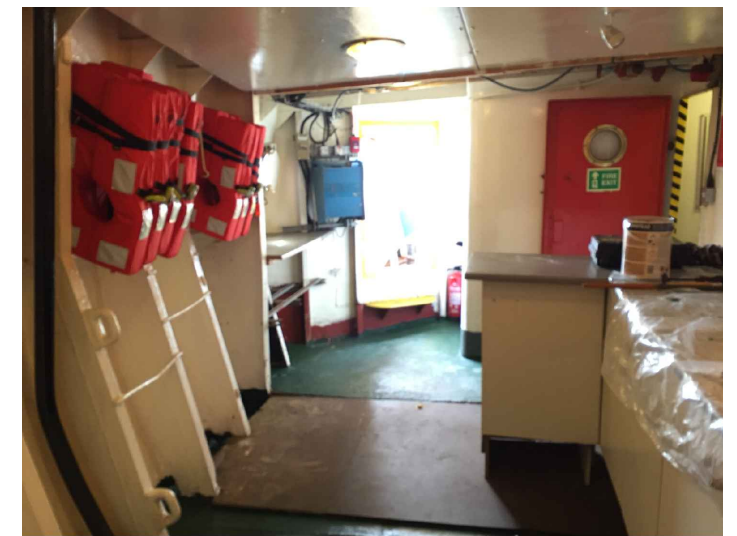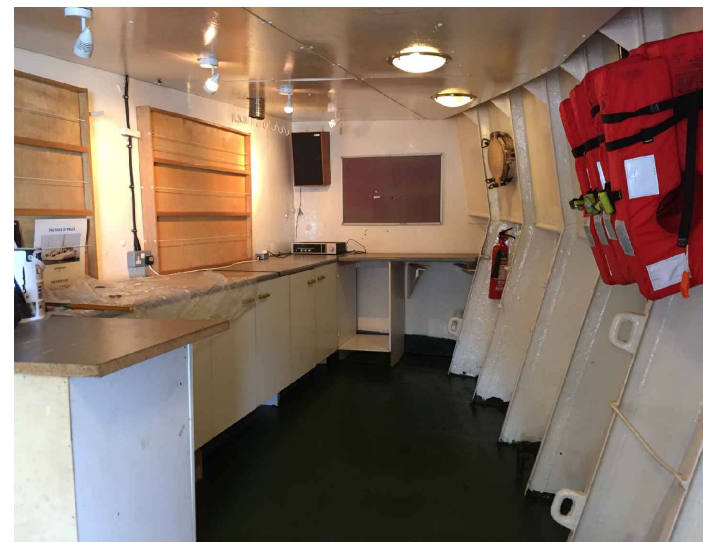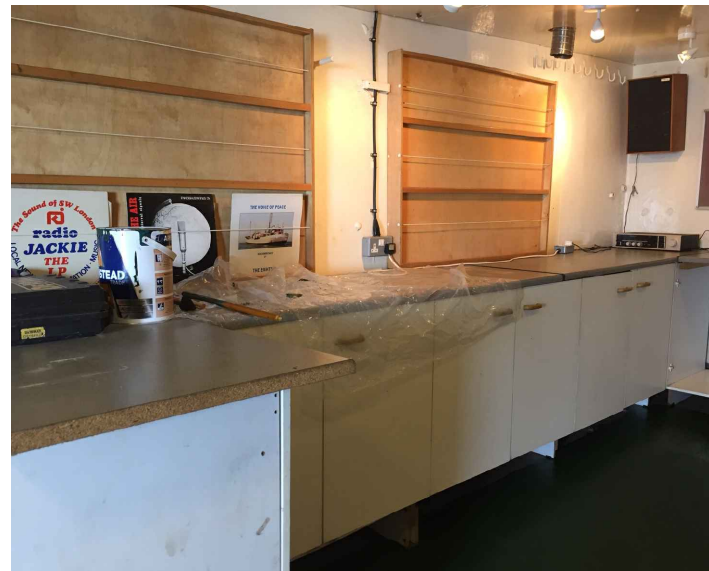

REV	DATE	BY	DESCRIPTION
RD		GJ	RECORD DRAWING

NOTES
 Copyright Notice
 This drawing is subject to Copyright © Ross Revenge Plans (2015-2017). Reg No 284707913 and may not be altered, reproduced or used other than for the purpose which it is issued.
 Terms of Use
 Ross Revenge Plans utilize Digital Rights Management (DRM) on all products. Use of this file denotes the recipient's acceptance of our DRM policies. Copy available on request.



ROSS REVENGE

CAROLINE SHOP PLAN LAYOUT

Date: JAN 2016	Scale: 1:50
Drawn: CJOHNSON	Eng: GJ
File Ref:	Checked By:
Drawing No:	Sheet Size: A3
319-RR-MP-014	
RECORD DRAWING	

A3