


ROSS REVENGE CURRENT TRANSMITTER MAST - INSTALLED 2012

SECTION NUMBER	SECTION HEIGHT (METRES)	SECTION WEIGHT (KG)	BASE WIDTH (METRES)		SECTION NUMBER	
6	3.05	51	0.5		6	
5	3.05	51	0.5		42.2 x 4MM LEGS 12MM DIA BRACINGS	5
4	6.10	218	0.95		48.3 x 4MM LEGS 12MM DIA BRACINGS	4
3	6.10	297	1.40		48.3 x 5MM LEGS 50x50x6 BRACINGS 8 PER FACE	3
2	6.10	369	1.85		60.3 x 5MM LEGS 50x50x6 BRACINGS 8 PER FACE	2
1	6.10	471	2.286		76.1 x 5MM LEGS 50x50x6 BRACINGS 8 PER FACE	1


30500

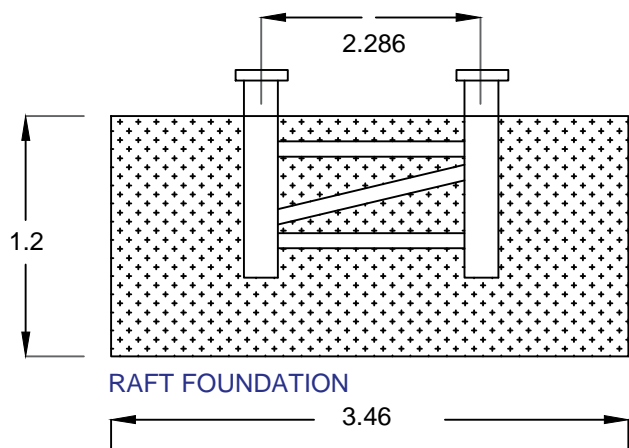

RAFT FOUNDATION

ALL FLANGES ARE 3 POINT FIXINGS
ALL BOLTS/NUTS 8MM

TUBE LEGS 76.1 x 5MM
BRACINGS 60x60x6

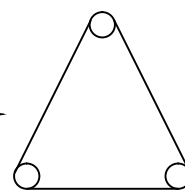

REVISIONS	NOTES



ROSS REVENGE

TX MAST DIMENSIONS

Drawn: G	Eng: G	Checked by:
Rev: 01	Sheet: A3	
Drawing No: 319-RR-MP-035		
RECORD DRAWING		