
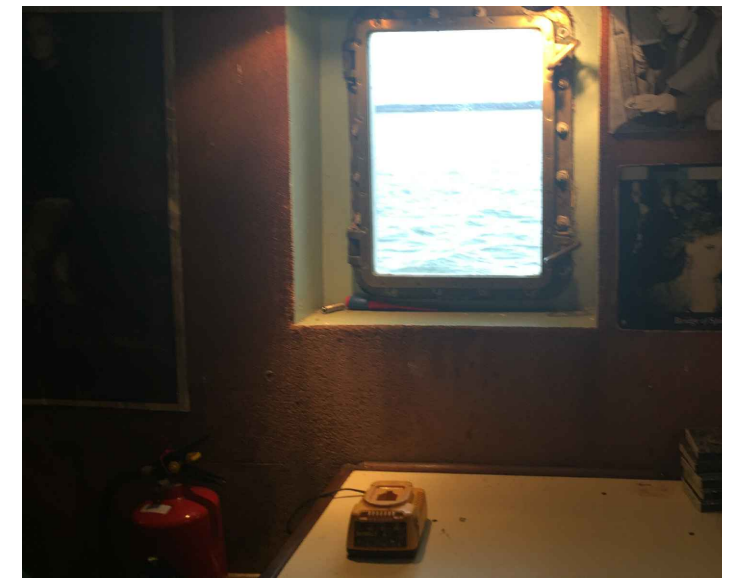


A

B

C

D

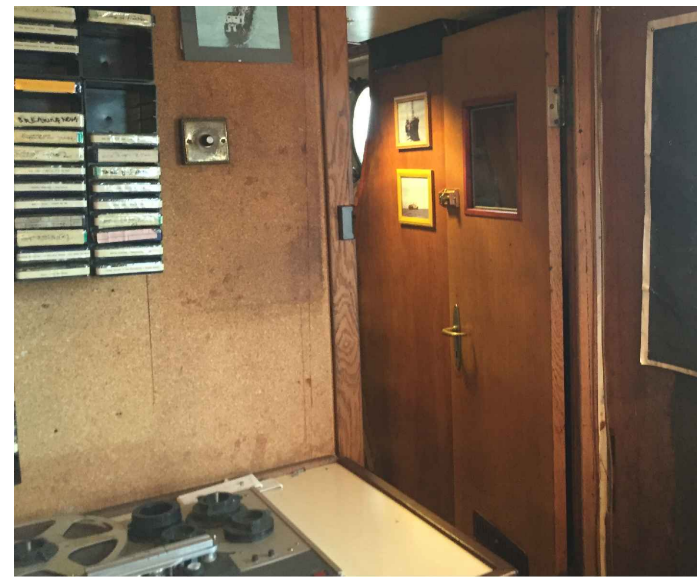

| REV | DATE | BY | DESCRIPTION    |
|-----|------|----|----------------|
| RD  |      | GJ | RECORD DRAWING |

**NOTES**  
 Copyright Notice  
 This drawing is subject to Copyright © Ross Revenge Plans (2015-2017) - Reg No 284707913 and may not be altered, reproduced or used other than for the purpose which it is issued.  
 Terms of Use  
 Ross Revenge Plans utilize Digital Rights Management (DRM) on all products. Use of this file deems the recipient's acceptance of our DRM policies. Copy available on request.

RRP

ROSS  
REVENGE

STUDIO 1  
PLAN  
LAYOUT

|                |                |
|----------------|----------------|
| Date: JAN-2016 | Scale: 1:50    |
| Drawn: GJ      | Eng: GJ        |
| Checked By: AB | Sheet Size: A3 |
| File Ref:      |                |
| Drawing No:    | 319-RR-MP-042  |
| Rev:           | RECORD DRAWING |

A3