
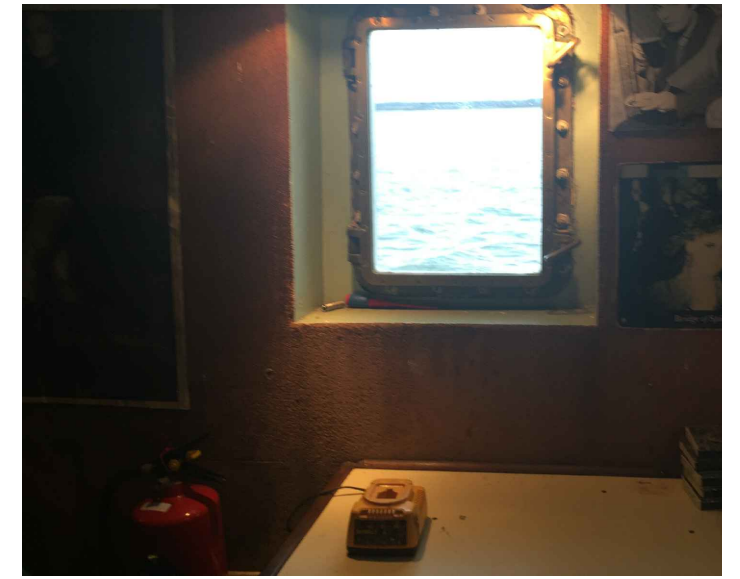


A

B

C

D

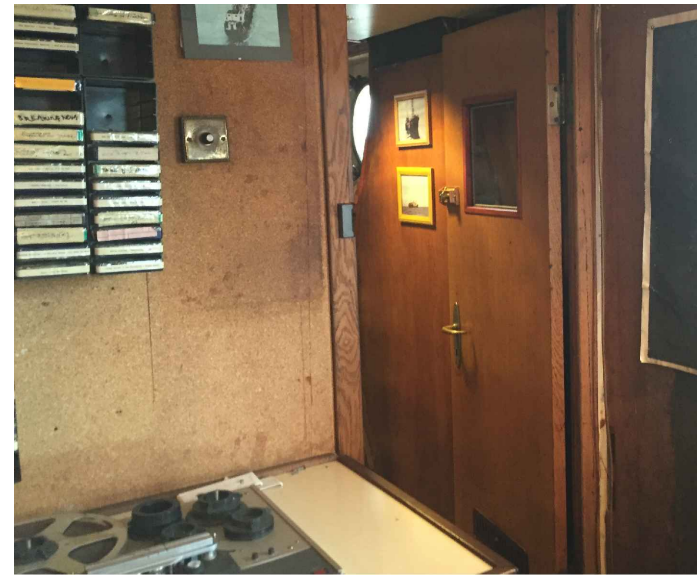

REVISIONS		NOTES		PROJECT	DRAWING TITLE	Date: JAN-2016	Scale: 1:50	
RD	GJ	RECORD DRAWING	<p>Copyright Notice This drawing is subject to Copyright © Ross Revenge Plans (2015-2017) - Reg No 284707913 and may not be altered, reproduced or used other than for the purpose which it is issued.</p> <p>Terms of Use Ross Revenge Plans utilise Digital Rights Management (DRM) on all products. Use of this file deems the recipient's acceptance of our DRM policies. Copy available on request.</p>	ROSS REVENGE	STUDIO 1 PLAN LAYOUT	Drawn: GJ	Eng: GJ	Checked By: AB
Rev	Date	By	Description	RRP		File Ref:	Sheet Size: A3	Drawing No: 319-RR-MP-042
								RECORD DRAWING

A3