
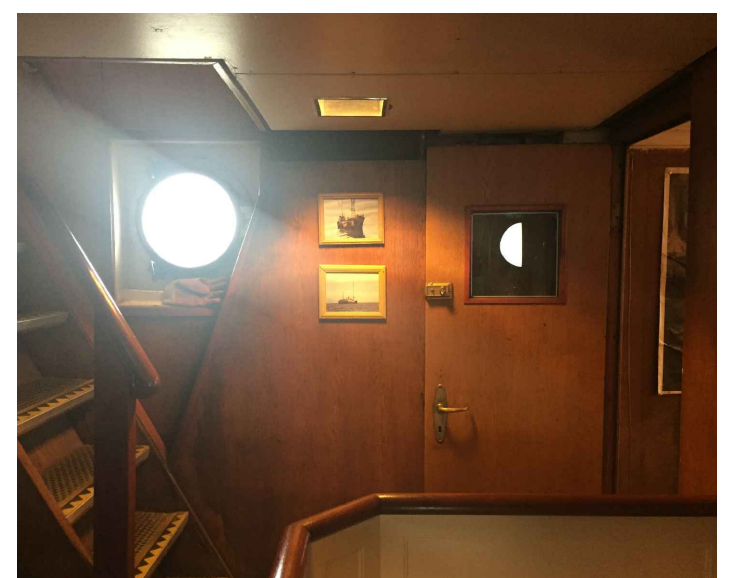
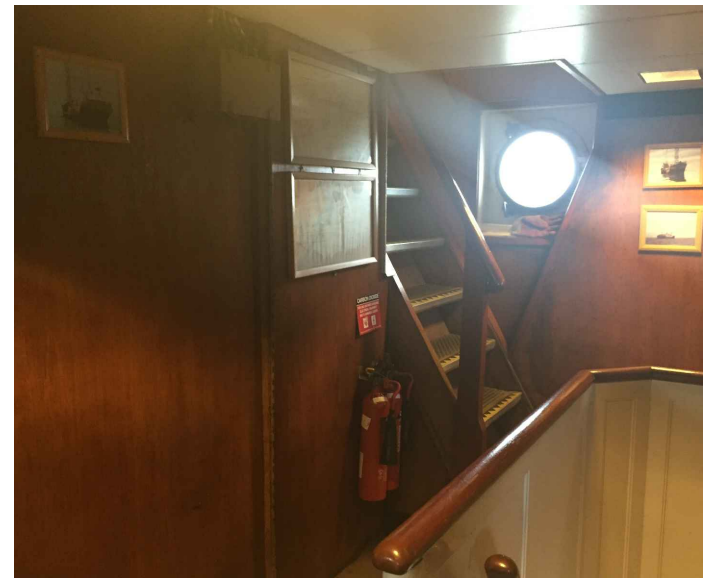


A

B

C

D

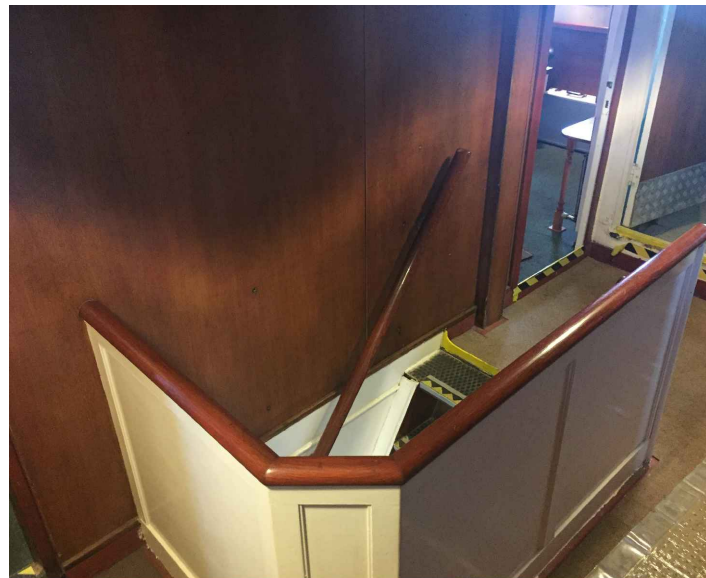

REVISIONS		NOTES		PROJECT	DRAWING TITLE		Date: FEB-2016	Scale: 1:50
Rev	Date	By	Description	ROSS REVENGE	STUDIO STAIRS PLAN LAYOUT		Drawn: CJOHNSON	Eng: GJ
							File Ref:	Checked By:
<p>Copyright Notice This drawing is linked to Copyright © Ross Revenge Plans (2015-2017) - Reg No 284707913 and may not be altered, reproduced or used other than for the purpose which it is issued.</p> <p>Terms of Use Ross Revenge Plans utilise Digital Rights Management (DRM) on all products. Use of this file denotes the recipient's acceptance of our DRM policies. Copy available on request.</p>						Drawing No:	319-RR-MP-047	
				A3		RECORD DRAWING		