


REFER TO DRAWING 199-RR-DS-001

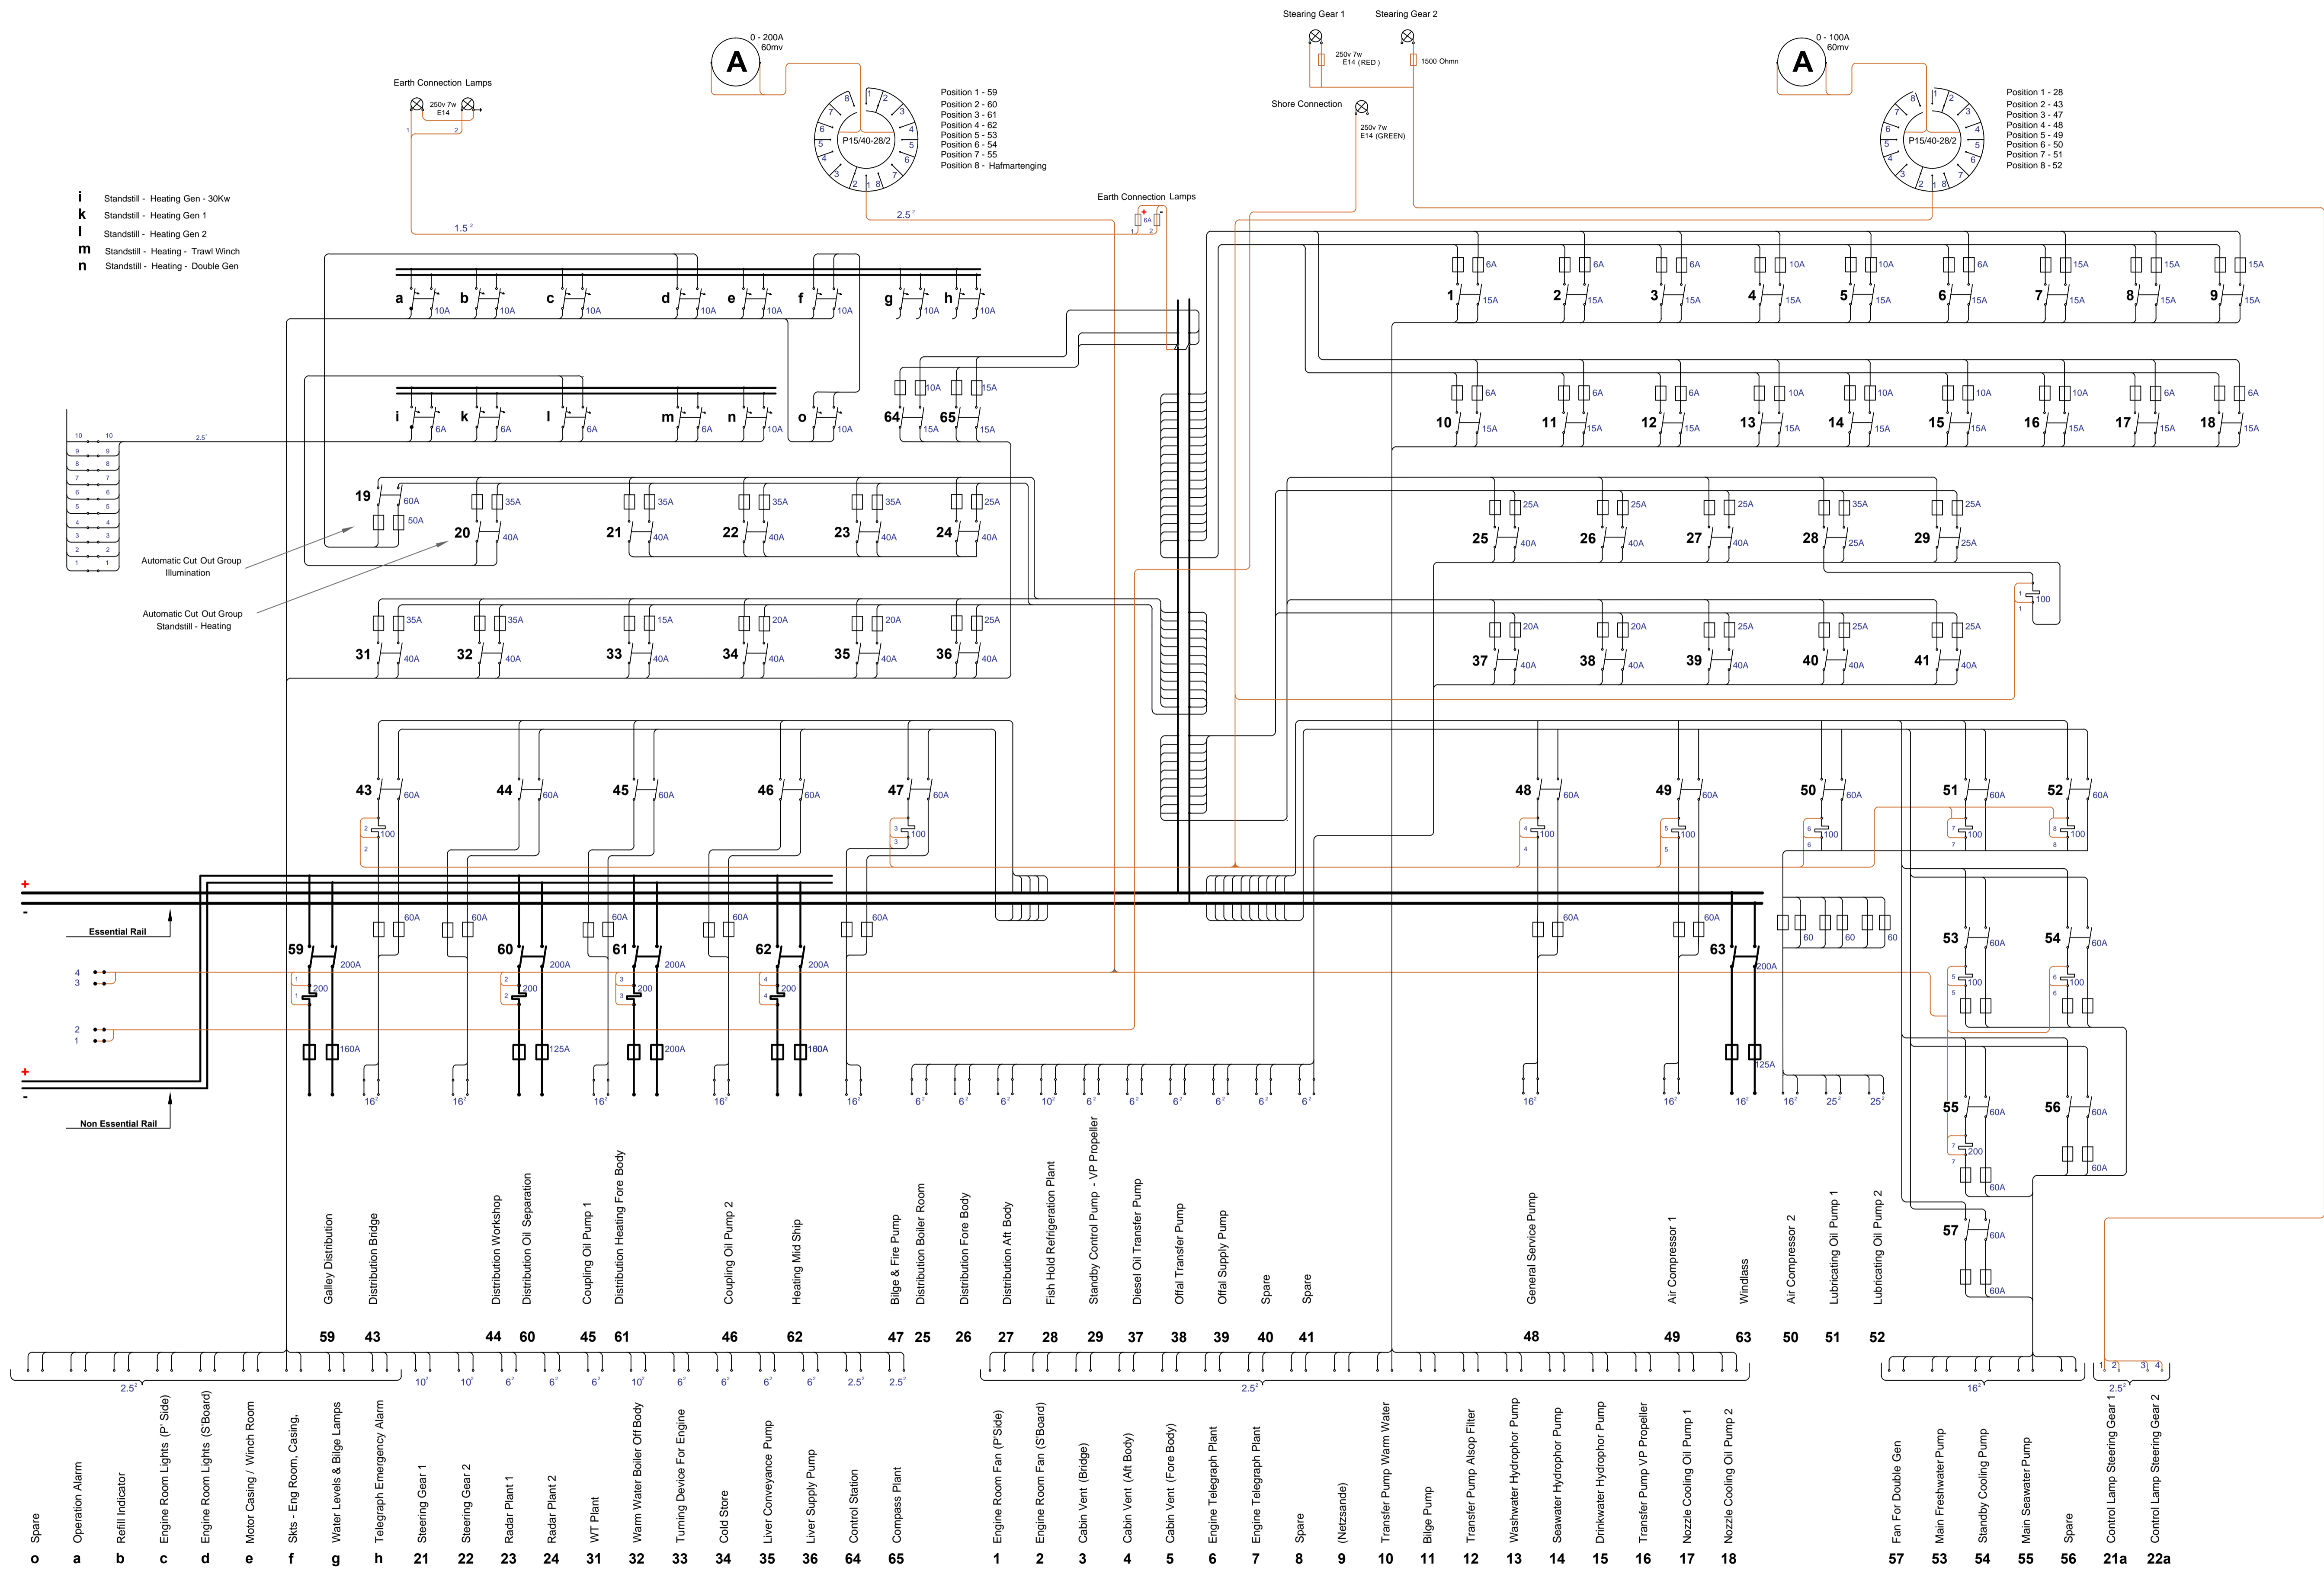

REV	DATE	BY	DESCRIPTION
RD	6.6.16	CJ	RECORD DRAWING

**NOTES**

**Copyright Notice**  
This drawing is subject to Copyright © Ross Revenge Plans (2015-2017) - Reg No 284707913 and may not be altered, reproduced or used other than for the purpose which it is issued.

**Terms of Use**  
Ross Revenge Plans utilize Digital Rights Management (DRM) on all products. Use of this file deems the recipient's acceptance of our DRM policies. Copy available on request.



**ROSS REVENGE**

**DC ELECTRICAL SCHEMATIC 2 OF 2**

Date: JUN 2016	Scale: NTS
Drawn: C:JOHNSON	Eng: Checked By:
File Ref:	Sheet Size: A1
Drawing No: <b>199-RR-DS-002</b>	Status: RECORD DRAWING

AI