
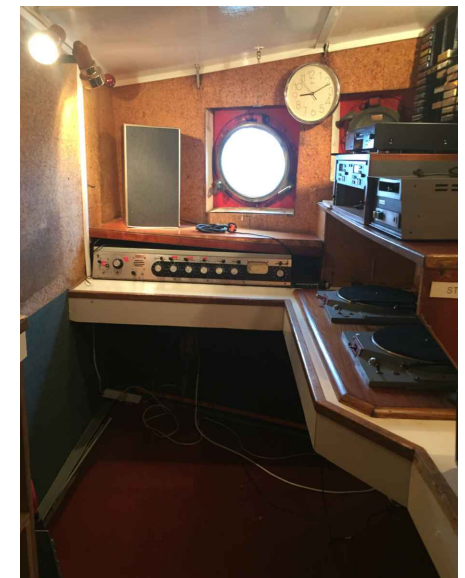


A

B

C

D

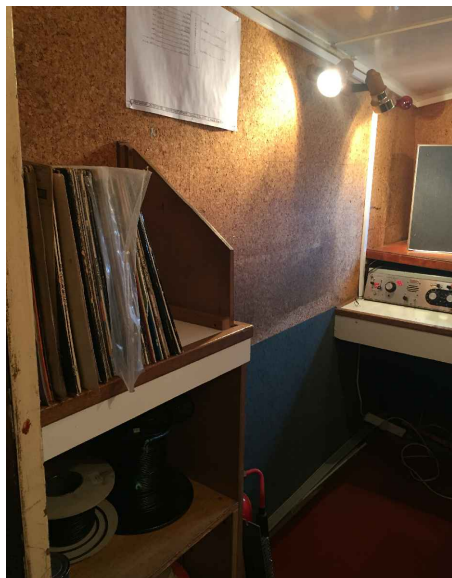

REVISIONS		NOTES	PROJECT	DRAWING TITLE	Date:	Scale:
		<p>Copyright Notice This drawing is subject to Copyright © Ross Revenge Plans (2015-2017) - Reg No 284707913 and may not be altered, reproduced or used other than for the purpose which it is issued.</p> <p>Terms of Use Ross Revenge Plans utilize Digital Rights Management (DRM) on all products. Use of this file denotes the recipient's acceptance of our DRM policies. Copy available on request.</p>	ROSS REVENGE	OVERDRIVE STUDIO PLAN LAYOUT	FEB-2016	1:50
					Drawn: GJ	Eng: GJ
					File Ref:	Checked By:
						Sheet Size: A3
					Drawing No:	319-RR-MP-008
						RECORD DRAWING

A3



ROSS REVENGE

OVERDRIVE STUDIO PLAN LAYOUT

Date: FEB-2016 Scale: 1:50
 Drawn: GJ Eng: GJ Checked By:
 File Ref: Sheet Size: A3
 Drawing No: 319-RR-MP-008
 RECORD DRAWING