

**DECK**

**CAROLINE SHOP**





RELIGIOUS STUDIO

LADDER

**TOOL STORE**

**MESS**

**PROVISIONS**

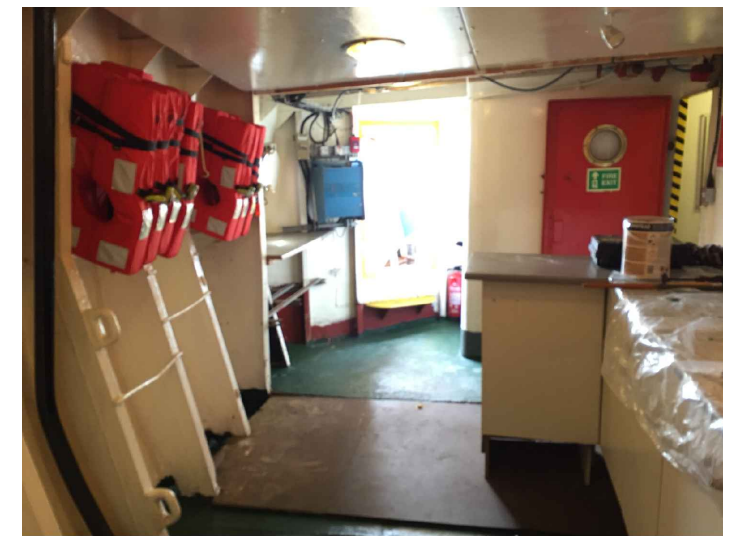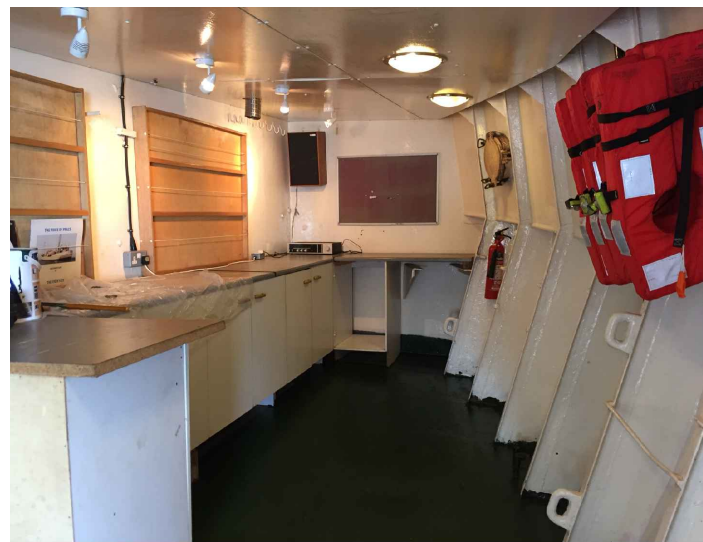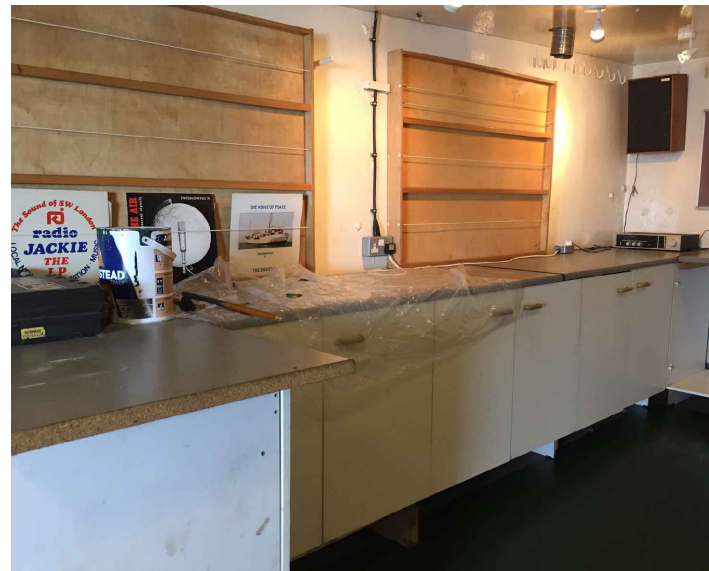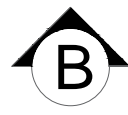

REV	DATE	BY	DESCRIPTION
RD		GJ	RECORD DRAWING

**NOTES**  
 Copyright Notice  
 This drawing is subject to Copyright © Ross Revenge Plans (2015-2017). Reg No 284707913 and may not be altered, reproduced or used other than for the purpose which it is issued.  
 Terms of Use  
 Ross Revenge Plans utilize Digital Rights Management (DRM) on all products. Use of this file denotes the recipient's acceptance of our DRM policies. Copy available on request.



**ROSS REVENGE**

**CAROLINE SHOP PLAN LAYOUT**

Date: JAN 2016	Scale: 1:50
Drawn: CJOHNSON	Eng: GJ
File Ref:	Checked By:
Drawing No: 319-RR-MP-014	Sheet Size: A3
RECORD DRAWING	

A3