
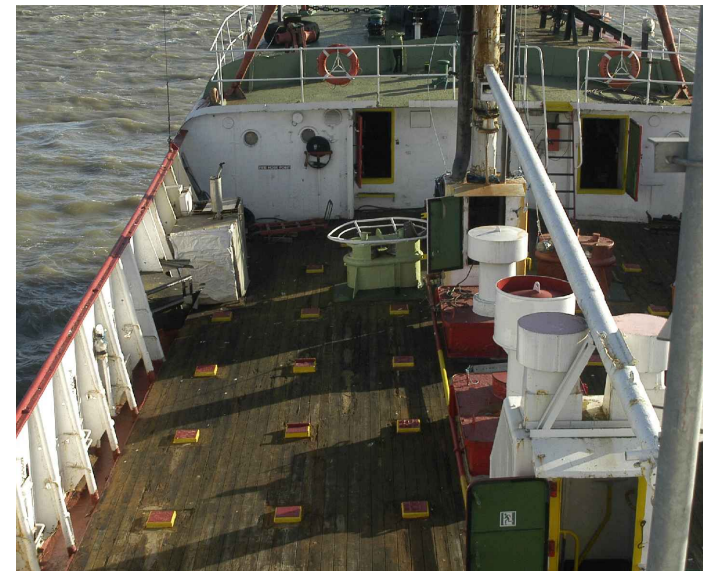


A

B

C

D

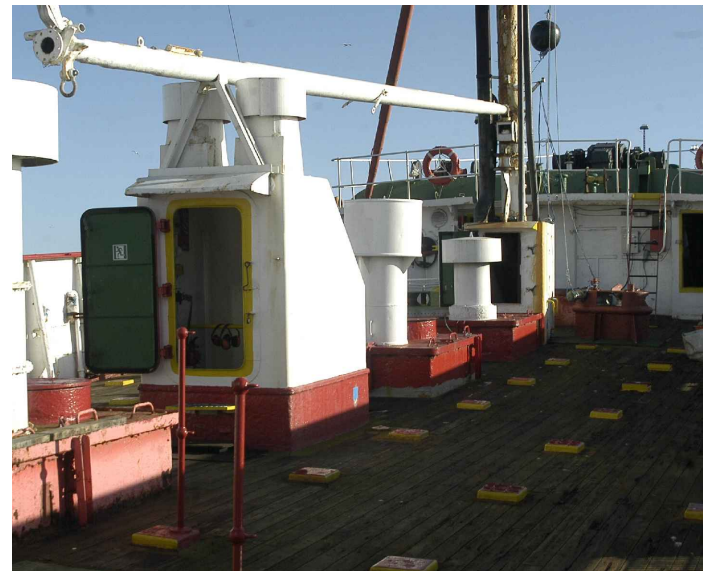

REV	DATE	BY	DESCRIPTION

NOTES
 Copyright Notice
 This drawing is subject to Copyright © Ross Revenge Plans (2015-2017) - Reg No 28470913 and may not be altered, reproduced or used other than for the purpose which it is issued.
 Terms of Use
 Ross Revenge Plans utilize Digital Rights Management (DRM) on all products. Use of this file denotes the recipient's acceptance of our DRM policies. Copy available on request.



ROSS REVENGE

MAIN DECK PLAN LAYOUT (1)

Date: FEB-2016	Scale: 1:50
Drawn: CJOHNSON	Eng: GJ
File Ref:	Checked By:
Drawing No:	Sheet Size: A3
319-RR-MP-025	
RECORD DRAWING	

A3