


A

B

C

D

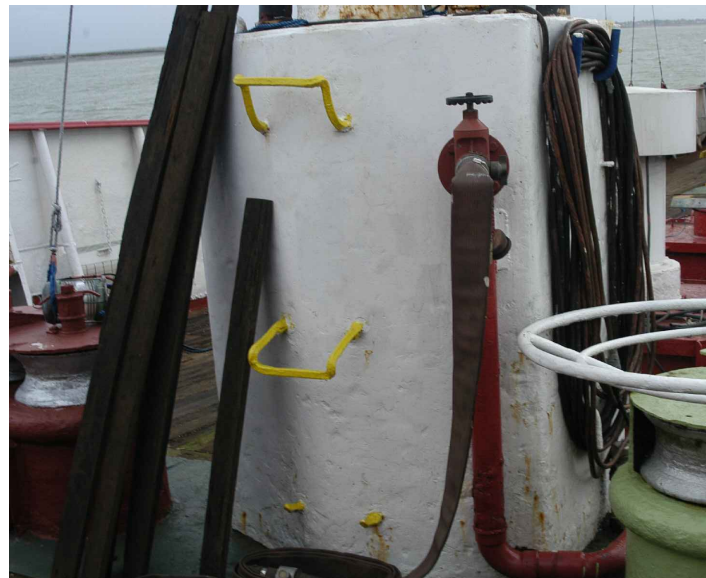

REV	DATE	BY	DESCRIPTION

NOTES

Copyright Notice
 This drawing is subject to Copyright © Ross Revenge Plans (2015-2017) - Reg No 284707913 and may not be altered, reproduced or used other than for the purpose which it is issued.

Terms of Use
 Ross Revenge Plans utilizes Digital Rights Management (DRM) on all products. Use of this file denotes the recipient's acceptance of our DRM policies. Copy available on request.



PROJECT
 ROSS REVENGE

DRAWING TITLE
 MAIN DECK PLAN LAYOUT (3)

Date: JAN-2016	Scale: 1:50
Drawn: CJ	Eng: GJ
File Ref:	Checked By:
Drawing No: 319-RR-MP-027	Sheet Size: A3
RECORD DRAWING	

A3