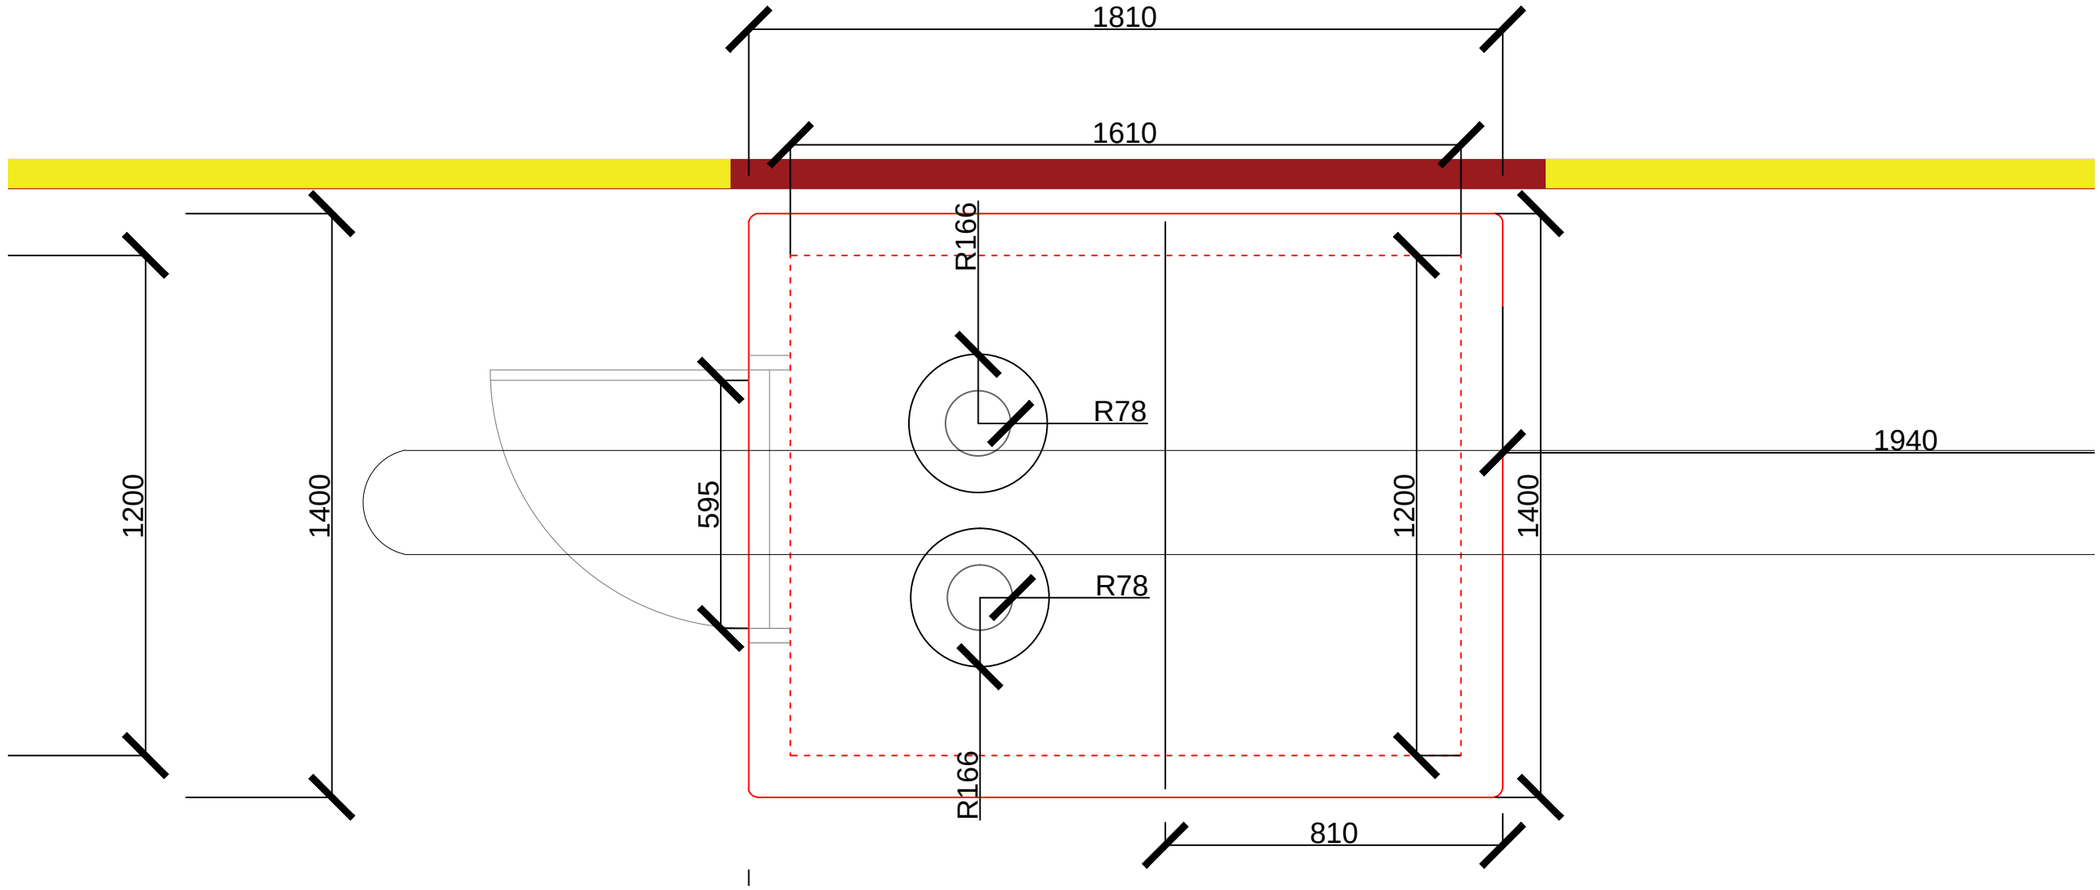

A B C D

REVISIONS				NOTES		PROJECT	DRAWING TITLE		
				Copyright Notice This drawing is subject to Copyright © Ross Revenge Plans (2015-2017) - Reg No 284707913 and may not be altered, reproduced or used other than for the purpose which it is issued. **Terms of Use** Ross Revenge Plans utilise Digital Rights Management (DRM) on all products. Use of this file deems the recipients acceptance of our DRM policies. Copy available on request.	RRP	ROSS REVENGE	MAIN DECK PLAN LAYOUT (6)	Date: JAN-2016 Scale: 1:50 Drawn: GJ Eng: GJ Checked By: File Ref: Sheet Size: A3 Drawing No: 319-RR-MP-030
RD		GJ	RECORD DRAWING						
Rev	Date	By	Description		A3				Status: RECORD DRAWING