




MAIN DECK

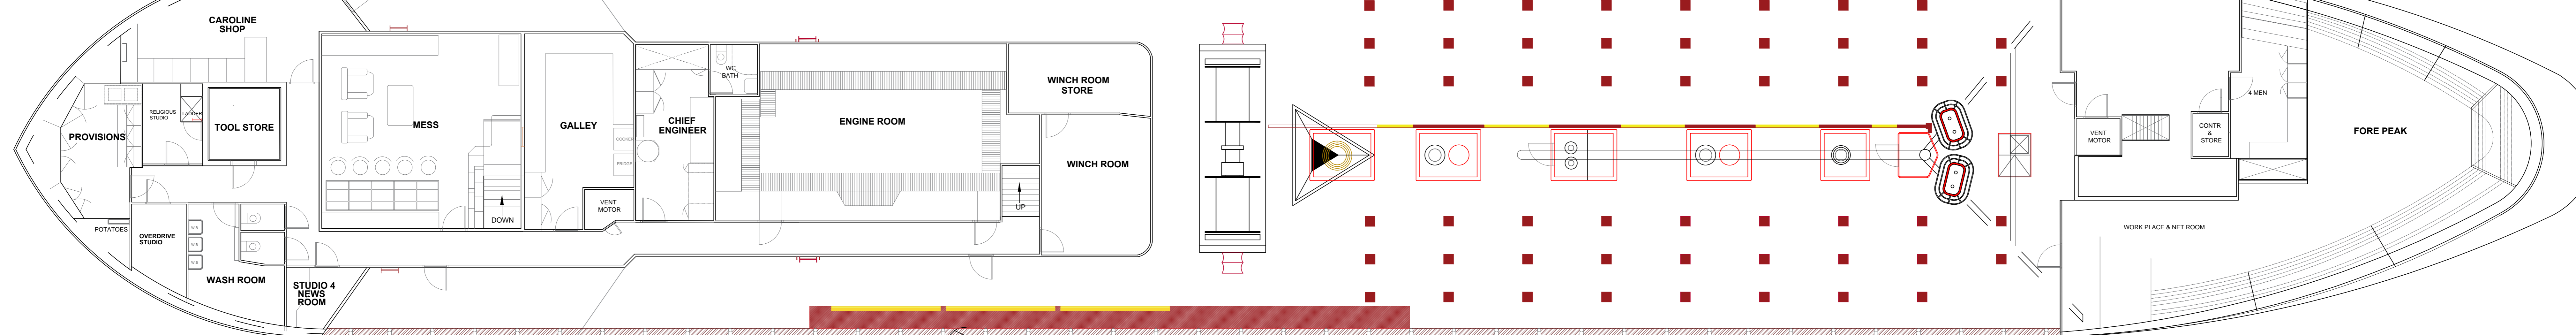

HOLD

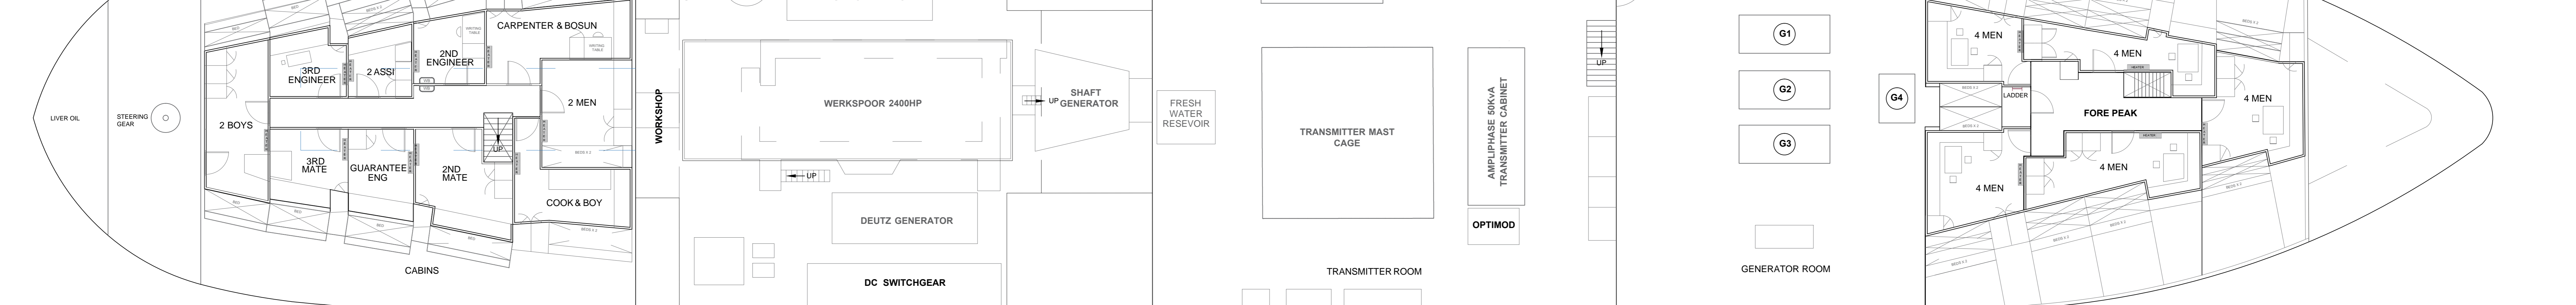

SIDE ELEVATION 1989

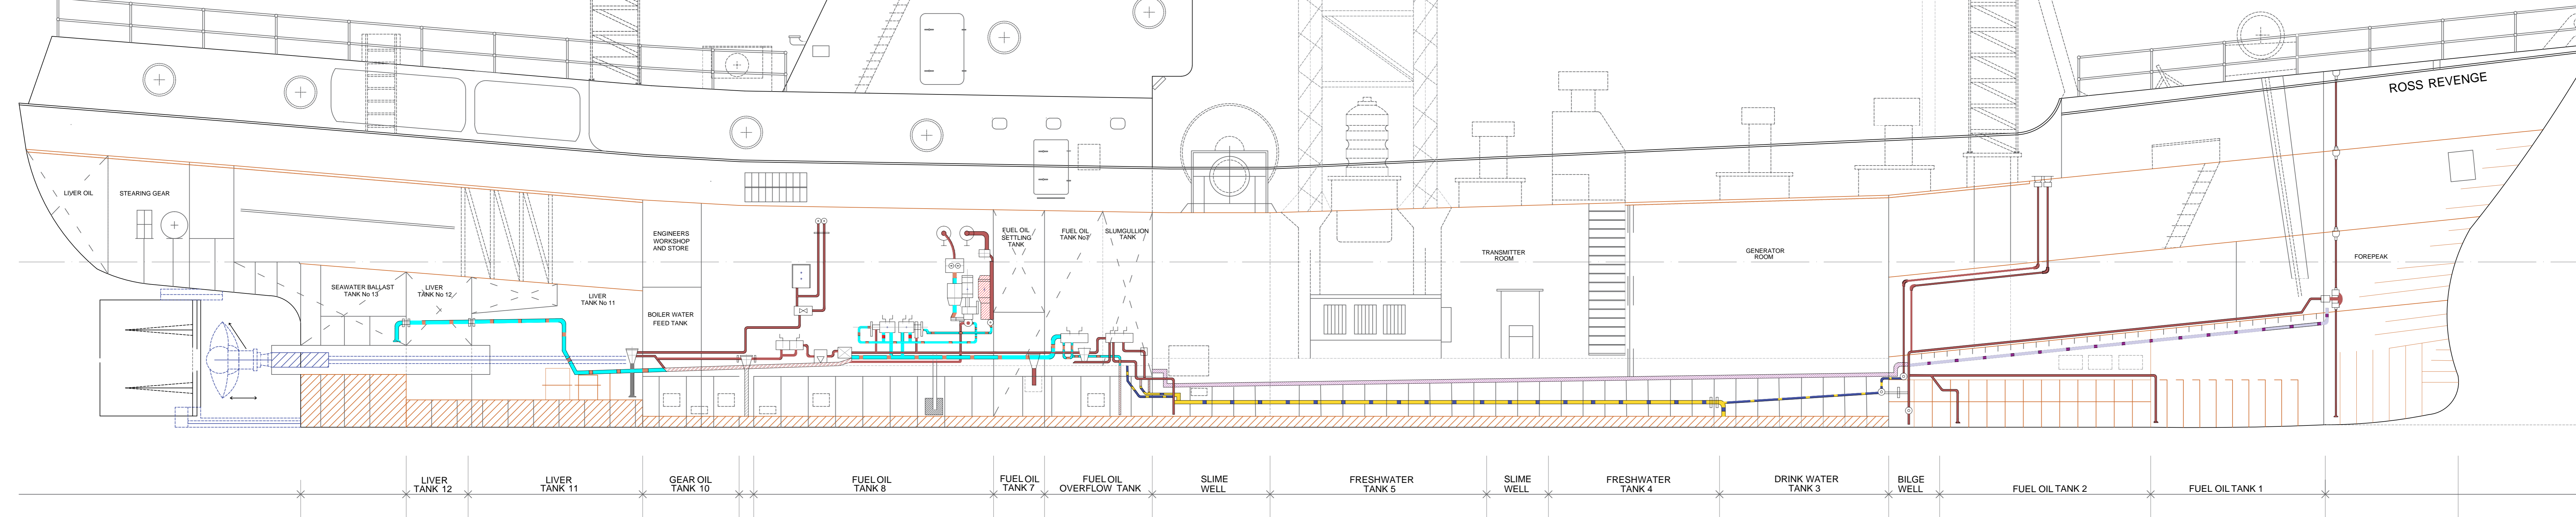

REV	DATE	BY	DESCRIPTION
RD		GJ	RECORD DRAWING

NOTES

Copyright Notice
 This drawing is subject to Copyright © Ross Revenge Plans (2015-2017) - Reg No 284707913 and may not be altered, reproduced or used other than for the purpose which it is issued.

Terms of Use
 Ross Revenge Plans utilise Digital Rights Management (DRM) on all products. Use of this file deems the recipients acceptance of our DRM policies. Copy available on request.

PROJECT: ROSS REVENGE PLANS

DRAWING TITLE: ROSS REVENGE LOWER DECK GA

AI

Date: MAR 2016	Scale: NTS
Drawn: G JOHNSON	Eng: GJ
File Ref:	Checked By: A1
Drawing No: 558-RR-GA-001	Sheet Size: A1
Status: RECORD DRAWING	